SUBMIT COMPLETED ORIGINAL APPLICATION, TAX STATEMENT AND FEE TO:

4 .

Bayfield County Zoning Department P.O. Box 58 Washburn, WI 54891 (715) 373-6138


APPLICATION FOR BAYFIELD COUNTY, V

Bayfield Co. Zonii

INSTRUCTIONS: No permits will be issued until all fees are paid. Checks are made payable to: Bayfield County Zoning Department.

	\G/22	REEN ISSUED TO APPLICANT
Application No.:	Amount Paid: \$75.00 805	field Co. Zoning Dent
	Zoning District A-1 (-2453)	JUN 22 2011
	Application No.: 11007 H.A. III	

	12.10 * 24 May 20 12.10
Manual Guilton 7-1-11 Inspector Date of Approval	Signed $M_{ m in}$
mobile home.	condition: pastery mother home must be prior to the placement of the new
Variance (B.O.A.) #	Mitigation Plan Required: Yes □ No ☑
Date of Inspection 6-29-1/	representations. By M. Fintale
ty lives per oumeis	Reason for Denial:
Permit Denied (Date)	Date 7.8 11 Permit Number 11 - 0.40 4
Commectorie 7/8/11	Permit Issued: State Sanitary Number
(If you recei	* See Notice on Back APPLICANT — PLEASE COMPLETE REVERSE SIDE
Copy of Tax Statement or	Address to send permit 60820 Hwy 63 Masta
Date 6	or Authorized Agent (Signature) Unall Annie
providing and that it will be relied upon by Bayfield County in determining whether this information I (we) am (are) providing in or with this application. I (we) we described property at any reasonable time for the purpose of inspection.	I (we) declare that this application (including any accompanying information) has been examined by the (ws) and no the one of the formation (we) and (arc) providing and that it will be relied upon by Bayfield County in determining whether (we) acknowledge that I (we) am (arc) responsible for the detail and accuracy of all information I (we) am (arc) providing and that it will be relied upon by Bayfield County in determining whether (we) acknowledge that I (we) further accept liability which may be a result of Bayfield County relying on this information I (we) am (arc) providing in or with this application. I (we) consent to county officials charged with administering county ordinances to have access to the above described property at any reasonable time for the jurpose of inspection.
WITHOUT A PERMIT WILL RESULT IN <u>PENALTIES</u> And to the best of my (our) browledge and helief it is true, correct and complete. I	LI Residential Unter (explain) FAILURE TO OBTAIN A PERMIT OF STARTING CONSTRUCTION WITHOUT A PERMIT WILL RESULT IN PENALTIES TO DESCRIPTION OF THE CONTROL
	ding Addition (explain)
☐ External Improvements to Principal Building (explain)	Residential Accessory Building (explain)
☐ Special/Conditional Use (explain)	dition / Alteration (explain)
Commercial Other (explain)	Residence sq. ft. Garage sq. ft Com
☐ Commercial Accessory Building Addition (explain)	Deck sq. ft. OC Company Sq. ft. Deck(z) sq. ft.
☐ Commercial Accessory Building (explain)	Residence sq. ft. 77 4750 (Porch sq. ft
☐ Commercial Principal Building	* Residence wydeck-porch (# of bedrooms)
3) 20	or Principal Structure (# of bedrooms)
New Existing X	10/2
Distance from Shoreline: greater than 75 💥 75 to 40 🔲 less than 40 🛄	ucture in a Shoreland Zone? Yes X N, If yes.
	Telephone 7/5-765-4275(Home) (Work) Written A
	user wi syst
Allan Polkowski	Property Owner (UKBIC) + INTICK Contractor Address of Bronactiv (COS 20 HUIL 63 Plumber
Mat 4-15-19-202 -CC	Page 336 of Deeds Parcel I.D. C4-C
Acreage 45	Gov't LotLotBlockSubdivision
HC North, Range CS West. Town of Kelly	Use Tax Statement for Legal Description Legal Description 19 Township 5 Legal Description 14 of 14 of Section 19 Township
SPECIAL USE B.O.A. OTHER	LAND USE SANITARY PRIVY CONDITIONAL USE
CANT.	DO NOT START CONSTRUCTION UNTIL ALL PERMITS HAVE BEEN ISSUED TO APPLICANT. Changes in plans must be approved by the Zoning Department.

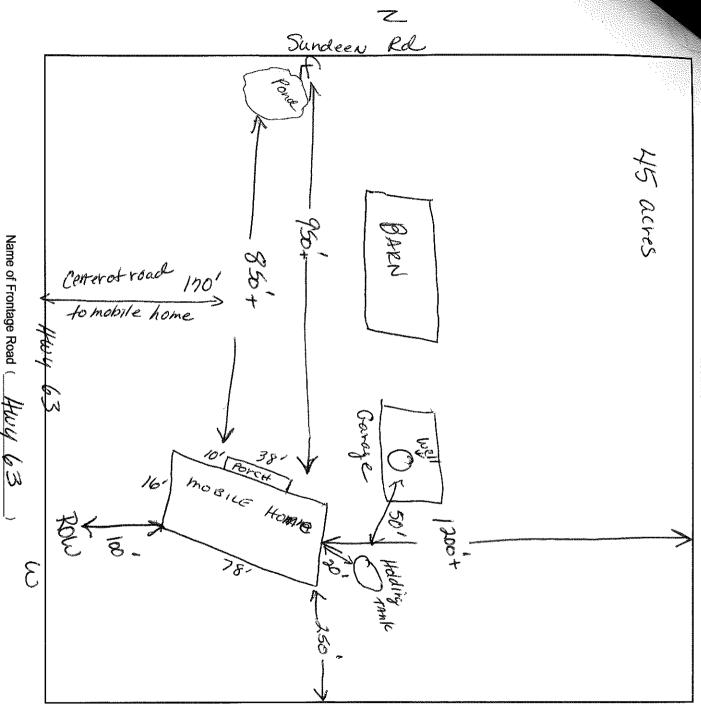

- Name the frontage road and use as a guideline, fill in the lot dimensions and indicate North (N)
- Ы Show the location, size and dimensions of the structure
- ယ Show the location, size and dimensions of attached deck(s), porch(s) or garage
- Show the location of the well, holding tank, septic tank and drain field

IMPORTANT
DETAILED PLOT PLAN
IS NECESSARY, FOLLOW
STEPS 1-8 (a-o) COMPLETELY.

4.

- Ċ Show the location of any lake, river, stream or pond if applicable
- Ò Show the location of other existing structures.
- Show the location of any wetlands or slopes over 20 percent
- ∞ Show dimensions in feet on the following:
- ù 'n Building to all lot lines
- Building to centerline of road
- 9.0 Building to lake, river, stream or pond Holding tank to closest lot line
- Holding tank to building Holding tank to well
- до∵о Holding tank to lake, river, stream or pond
- Privy to closest lot line

- Privy to building
- Privy to lake, river, stream or pond
- Septic Septic Tank and Drain field to closest lot line Septic Tank and Drain field to building
- ∄ Septic Tank and Drain field to well
- Septic Tank, and Drain field to lake, river, stream or pond.
- Well to building

*NOTICE: All Land Use Permits Expire One (1) Year From The Date Issued

For The Construction Of New One & Two Family Dwellings: ALL Municipalities Are Required To Enforce The Uniform Dwelling Code. You Must Contact Your Town Chairman / Clerk For More Information.

The local town, village, city, state or federal agencies may also require permits.

will not make an inspection until location(s) are staked or marked Stake or mark proposed location(s) of new building, holding tank, septic, drain field, privy, and well. Inspector New Qplace mobile home

Revised June 2008

3

the mobil SAME nome ocation